

# LAND

**For Sale - 5.02 Acres**  
**29278 N IL Route 83 Mundelein, Illinois**



**Site Area:** 5.02 Acres


**Access:** Gravel Road (intersects with Route 83)

**Present Use:** Vacant

**Zoning:** AG – County zoning Utilities: Well & Septic

**Sale Price:** \$177,000

**Remarks:** Most likely suited for residential development. New townhome development, Crossings of Mundelein, adjacent to the south. Mundelein Crossings retail center located just south at Route 83 and Route 60. No utilities, no frontage on Route 83. Offered “as-is” with no representations or warranties.

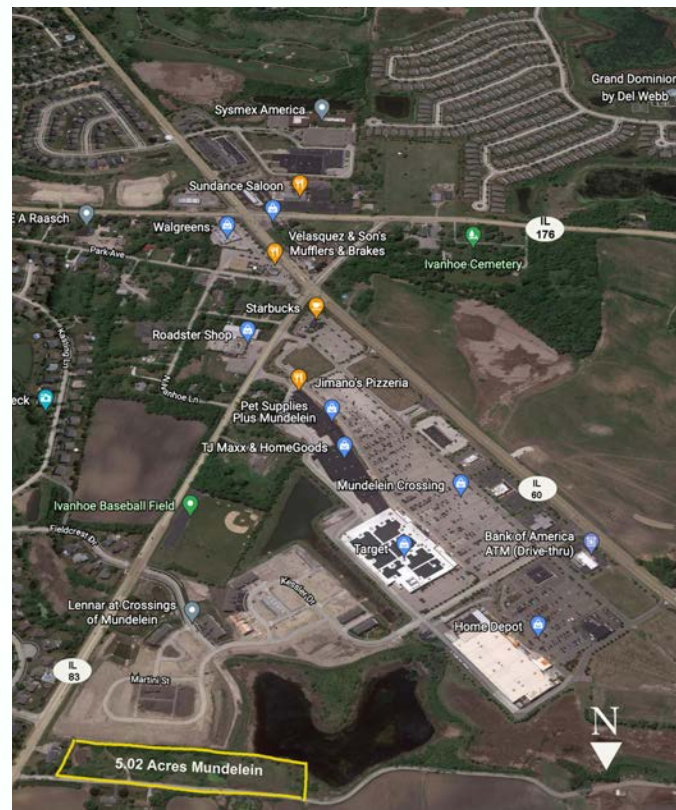

Above information is subject to verification and no liability for errors or omissions is assumed. Prices subject to change and listing may be withdrawn without notice.

TRI STATE REALTY  
**TSR**

[www.tristaterealty.com](http://www.tristaterealty.com)

35 Years of Success

Copyright Tri-State Realty, Inc. All World Right Reserved

**Contact: Robert Elbrecht**  
**847.360.1375 sales@tristaterealty.com**  
**P.O. Box 7860 Gurnee, Illinois**  
Commercial & Industrial Real Estate  
Licensed in Illinois and Wisconsin

**FOR SALE**  
**5.02 Acres**  
**29278 N IL Route 83**  
**Mundelein, Illinois**

**Site Area:** 5.02 Acres (Approximately 206' x 1062')

**Access:** Gravel Road (intersects with Route 83)

**Present Use:** Vacant

**Zoning:** AG – County zoning

**Utilities:** Well & Septic

**Sale Price:** \$177,000

**Remarks:** Most likely suited for residential development. New townhome development, Crossings of Mundelein, adjacent to the south. Mundelein Crossings retail center located just south at Route 83 and Route 60. No utilities, no frontage on Route 83. Offered “as-is” with no representations or warranties.

---

Above information is subject to verification and no liability for errors or omissions is assumed. Prices subject to change and listing may be withdrawn without notice.



[www.tristaterealty.com](http://www.tristaterealty.com)

35 Years of Success


Copyright Tri-State Realty, Inc. All World Right Reserved

**Contact: Robert Elbrecht**  
**847.360.1375 sales@tristaterealty.com**  
**P.O. Box 7860 Gurnee, Illinois**  
Commercial & Industrial Real Estate  
Licensed in Illinois and Wisconsin

# PLAT OF SURVEY - 5.02 Acres 29278 N. IL Rt. 83 Mundelein, IL 60060

PARCEL 1: THE SOUTH 204.96 FEET OF THE WEST 1,062.65 FEET OF THE NORTHWEST QUARTER OF THE SOUTHWEST QUARTER OF SECTION 14, AND ALSO THE SOUTH 174.96 FEET OF THE EAST 143.00 FEET OF THE NORTHEAST QUARTER OF THE SOUTHWEST QUARTER OF SECTION 15, TOWNSHIP 44 NORTH, RANGE 10, EAST OF THE THIRD PRINCIPAL MERIDIAN IN LAKE COUNTY, ILLINOIS.

PARCEL 2: EXPRESS, PERPETUAL EASEMENT, APPURTENANT TO PARCEL 1 OF THE REAL ESTATE, FOR INGRESS AND EGRESS OVER, UNDER AND ACROSS THE NORTH 30 FEET OF THE SOUTH 204.96 FEET LYING WEST OF THE CENTER LINE OF STATE ROUTE 83, (EXCEPT THAT PART THEREOF FALLING IN PARCEL 1), OVER, UNDER AND ACROSS THE SOUTH 30 FEET OF THE NORTH 280.6 FEET OF THE SOUTH 485.56 FEET LYING WEST OF THE CENTER LINE OF THE STATE ROUTE 83, IN THE NORTH HALF OF THE SOUTHWEST QUARTER OF SECTION 14, TOWNSHIP 44 NORTH, RANGE 10, EAST OF THE THIRD PRINCIPAL MERIDIAN, IN LAKE COUNTY, ILLINOIS, SUCH THAT THE BENEFITS AND BURDENS OF THE EASEMENT RUN WITH THE LAND AND ARE BINDING UPON AND ENURE TO THE HEIRS, ASSIGNS, SUCCESSORS, TENANTS AND PERSONAL REPRESENTATIVES OF THE ORIGINAL PARTIES TO THE EASEMENT.

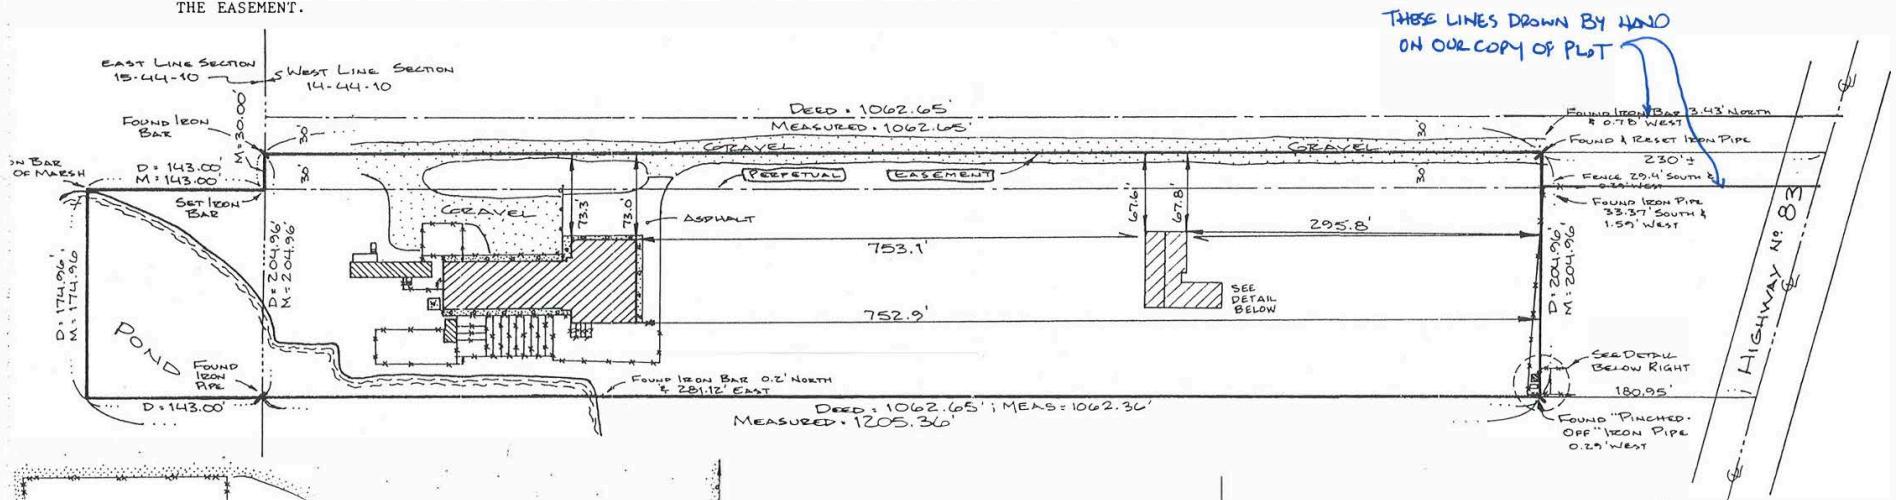

NOTE: THE EXISTING BUILDING AND STRUCTURES WERE DEMOLISHED AND NO LONGER EXIST

Above information is subject to verification and no liability for errors or omissions is assumed. Prices subject to change and listing may be withdrawn without notice.



www.tristaterealty.com

35 Years of Success

Copyright ©1990-2025 Tri-State Realty, Inc. All World Right Reserved

Contact: Robert Elbrecht  
847.360.1375 sales@tristaterealty.com

P.O. Box 7860 Gurnee, Illinois

Commercial & Industrial Real Estate

Licensed in Illinois and Wisconsin